


**AMENDED  
MAP SHOWING  
RECORD SURVEY  
OF SIERRA VISTA RANCHO**

LOCATED IN RANCHO LA SIERRA  
RIVERSIDE COUNTY CALIFORNIA

A.E. KELLER SURVEYOR

JUNE 1932

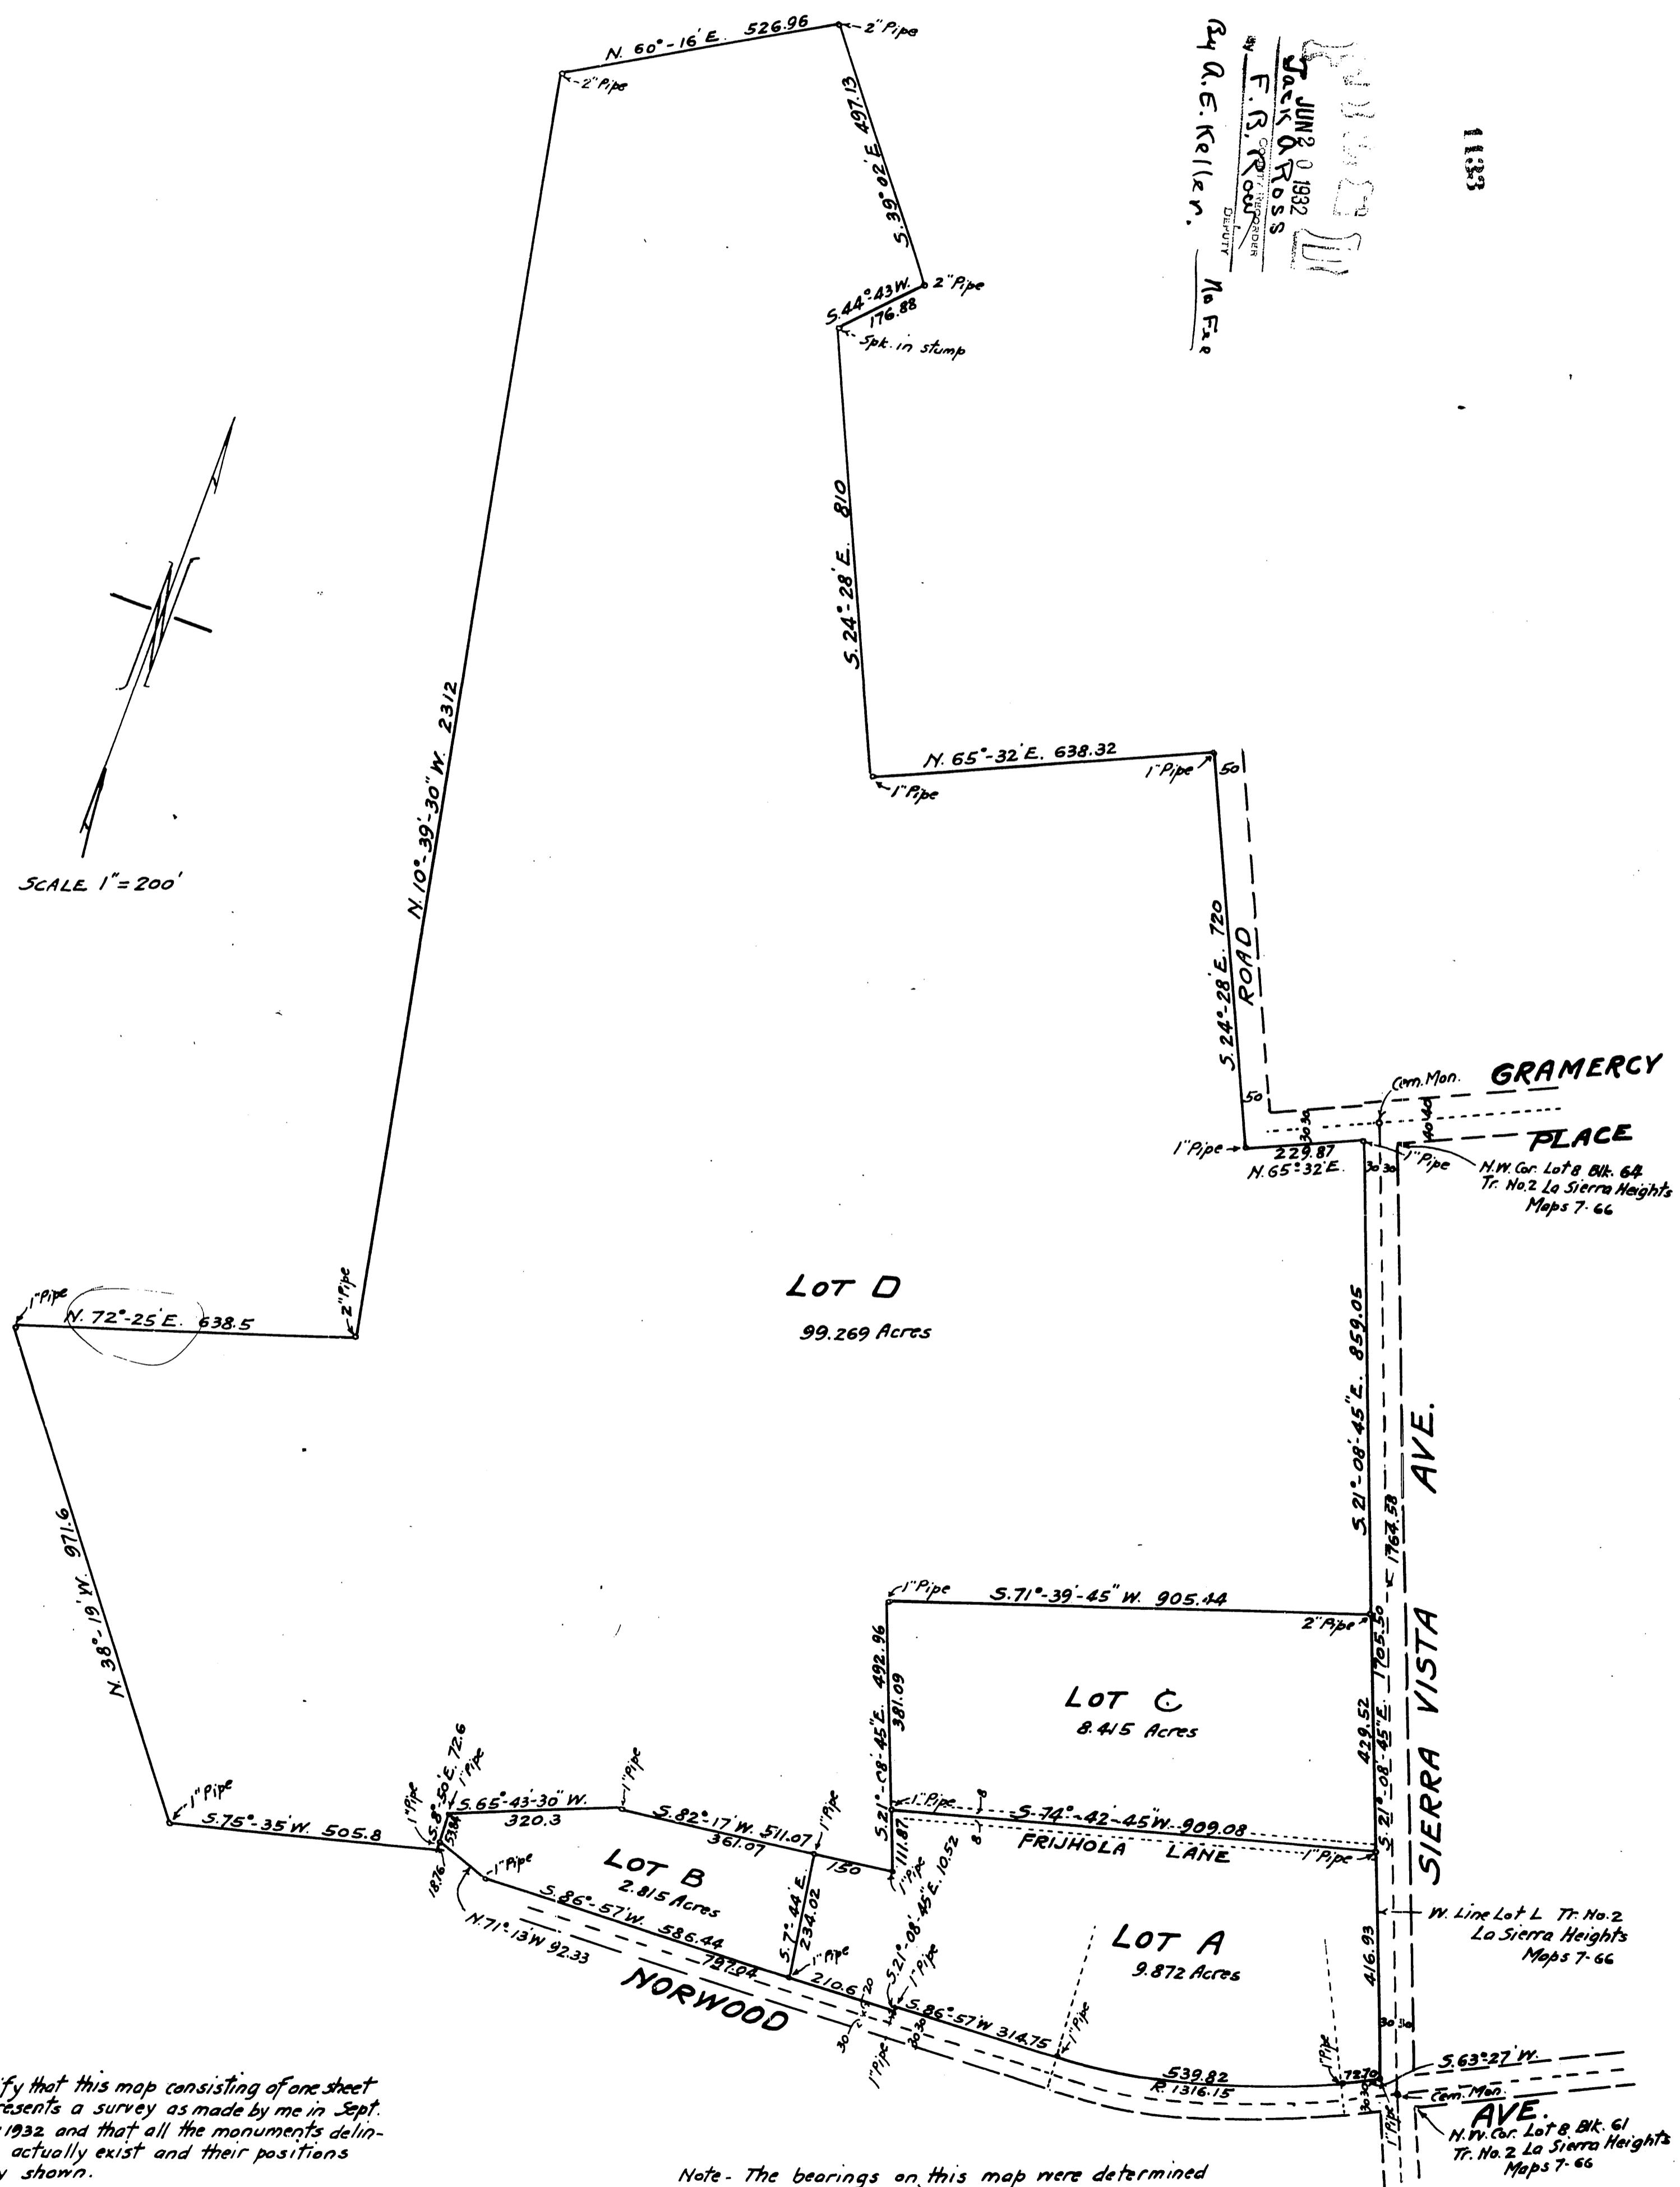

I hereby certify that this map consisting of one sheet  
correctly represents a survey as made by me in Sept.  
1931 and May 1932 and that all the monuments delineated  
thereon actually exist and their positions  
are correctly shown.

Albert E. Keller  
LICENSED SURVEYOR

Approved June 20, 1932  
A. G. Culver  
County Surveyor

Note - The bearings on this map were determined  
by an observation on Polaris.  
The only change shown hereon from original record survey  
map is location of lot line between Lots A and C.

RS 10 / 20